



RED-LINED DRAWING SHEETS

**consisting of Figs. 10b, 13, 14,
19b, 23b, 24 and 26**

**TO INDICATE REVISIONS,
OF U.S. PATENT APPLICATION
09/903,059**

**ATTORNEY DOCKET NO.
NS-4971 US**

**RECEIVED
JAN 14 2003
TECHNOLOGY CENTER 2800**

Fig.
10a

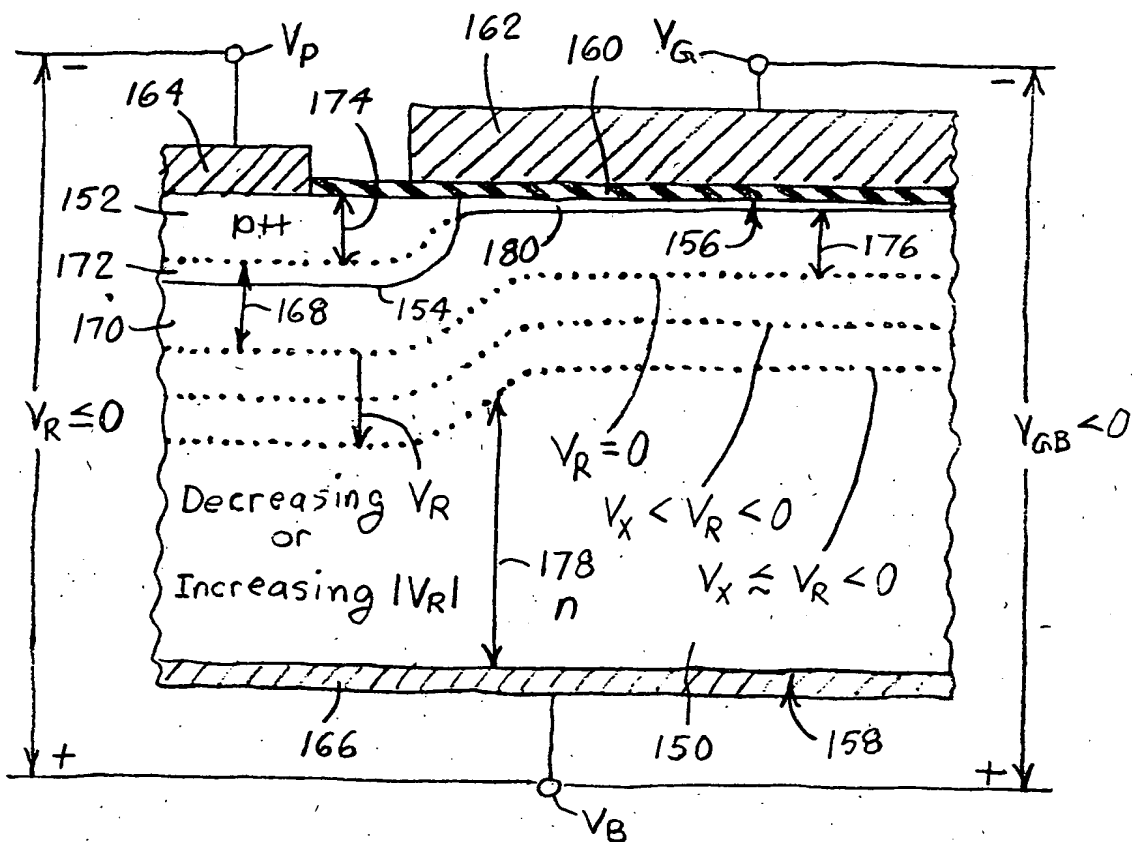
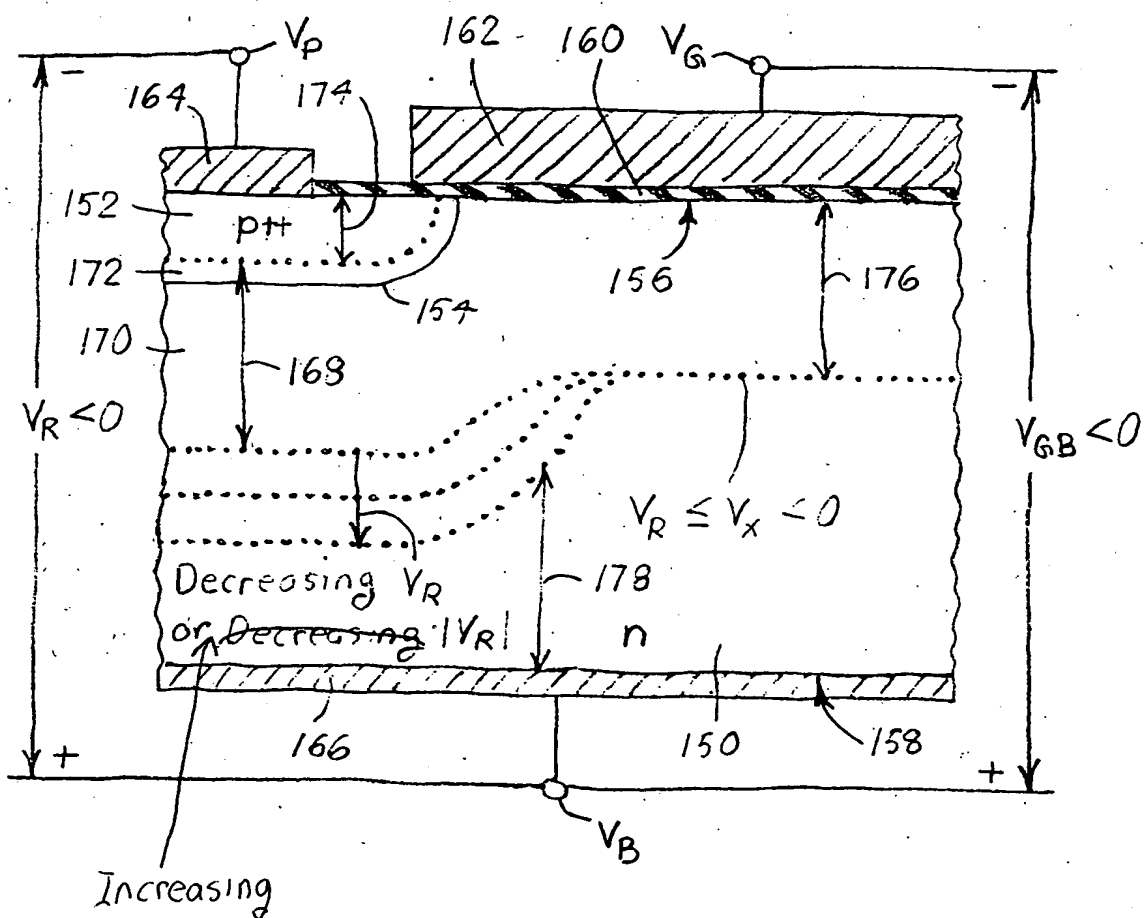


Fig.
10b



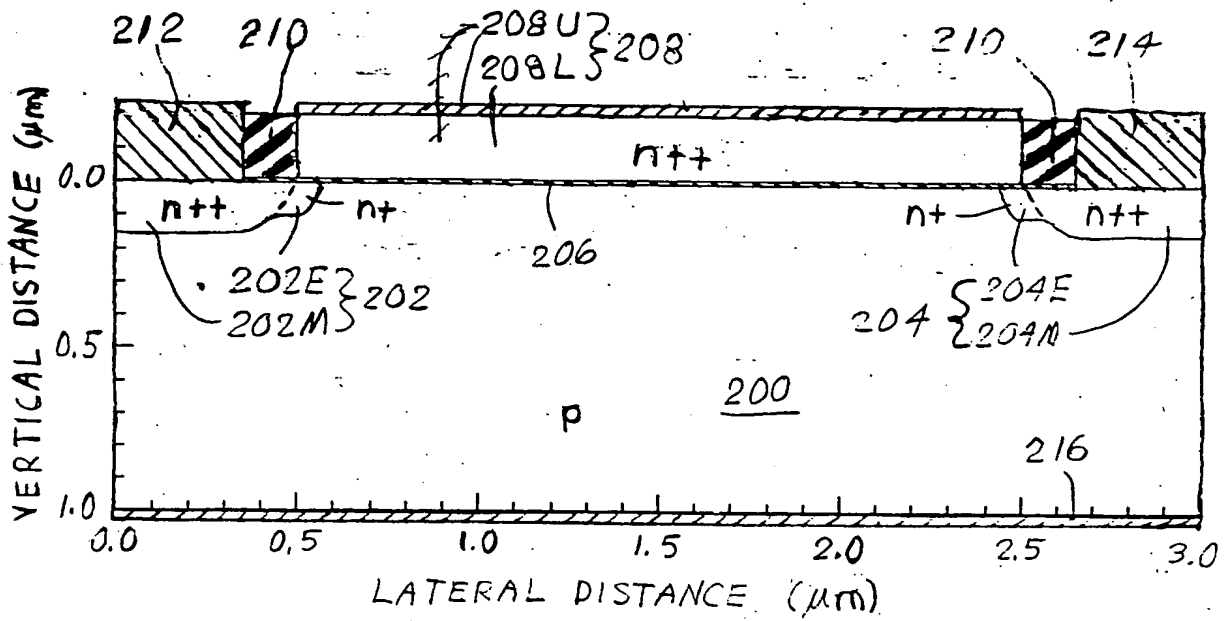


Fig. 13

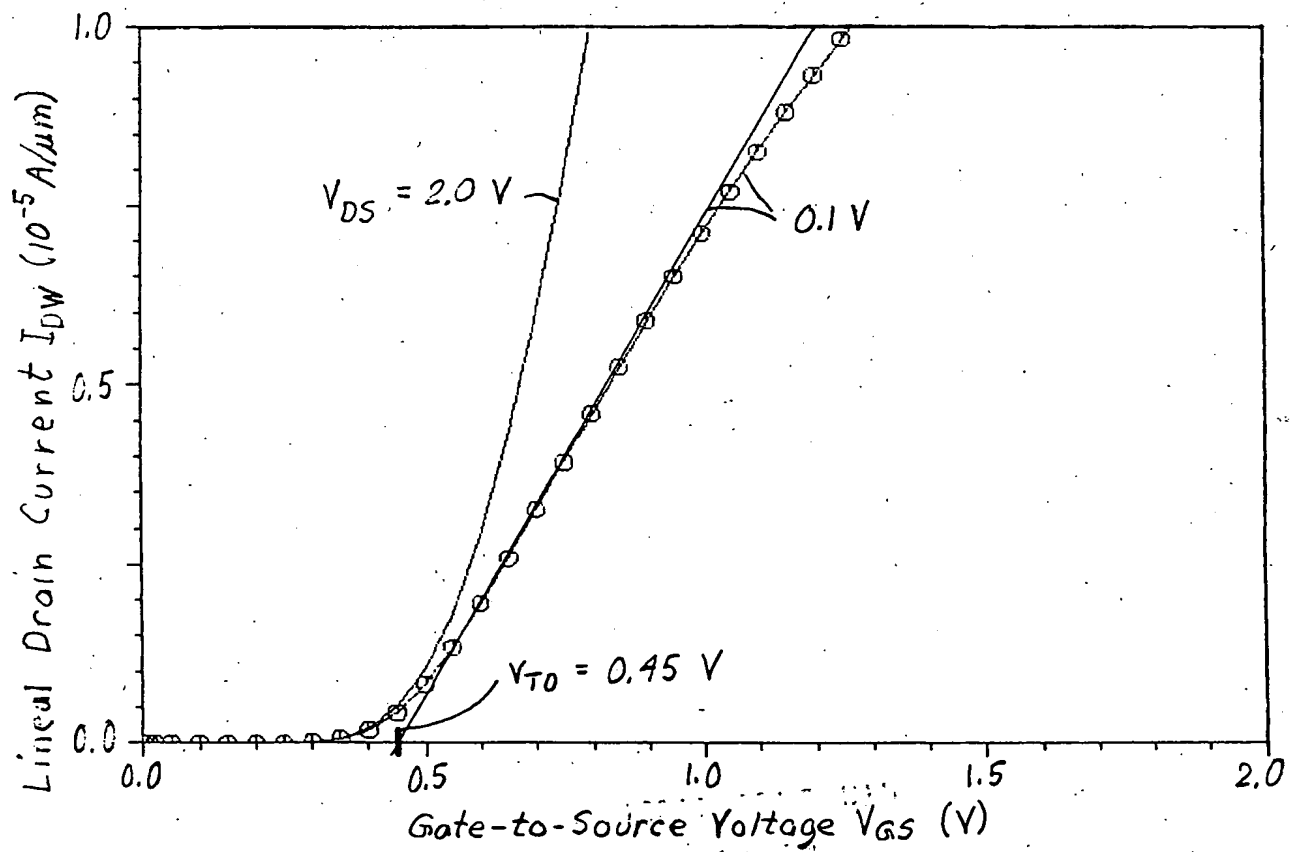


Fig. 14




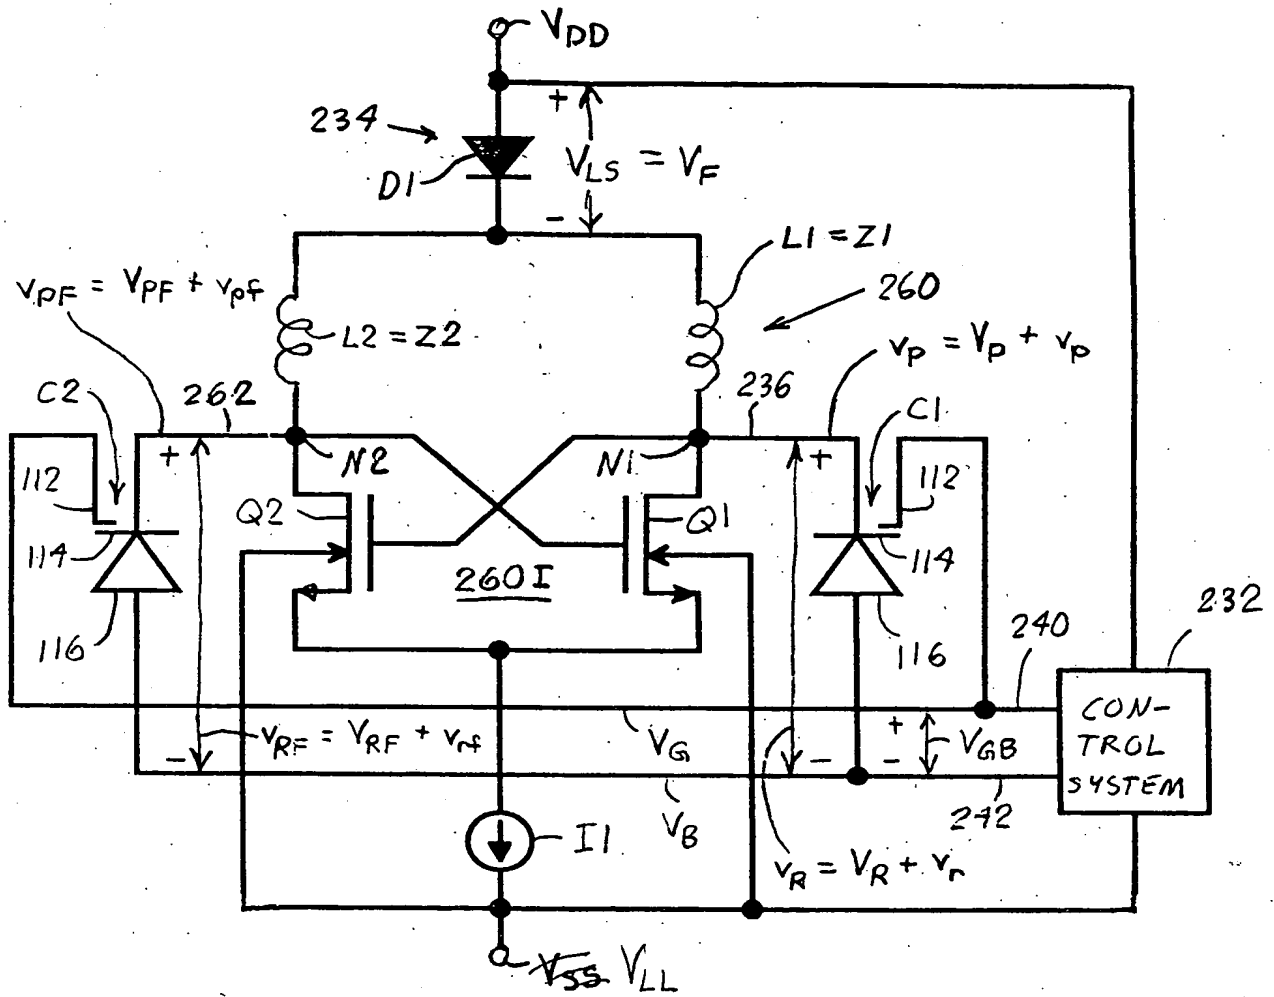


Fig. 19b



RECEIVED
JAN 14 2003
TECHNOLOGY CENTER 2800



NS-4971

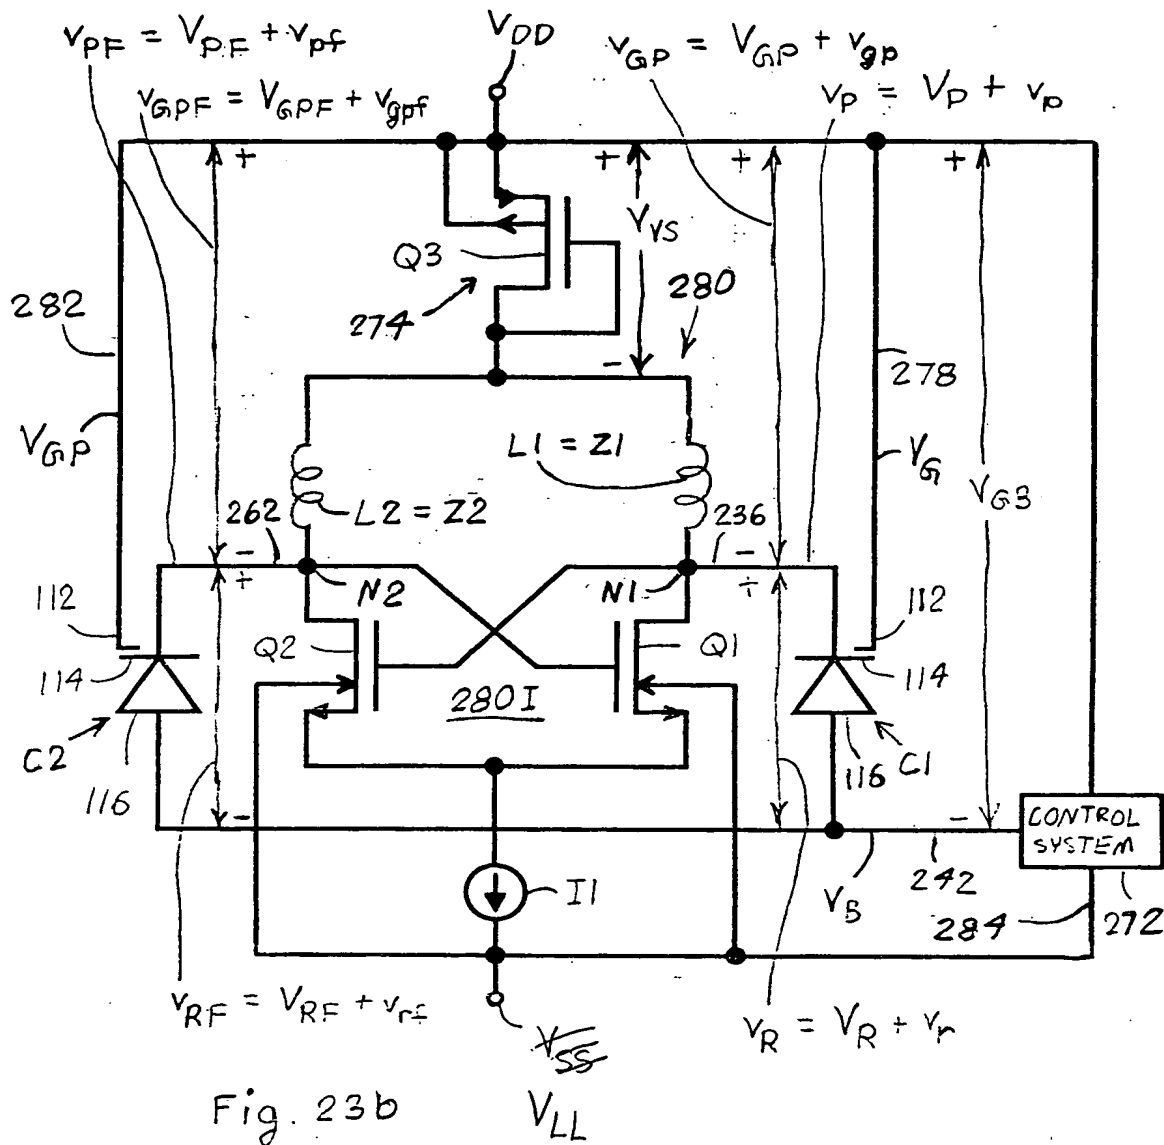

RECEIVED
JAN 14 2003
TECHNOLOGY CENTER 2800

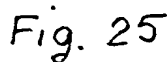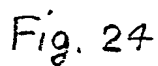

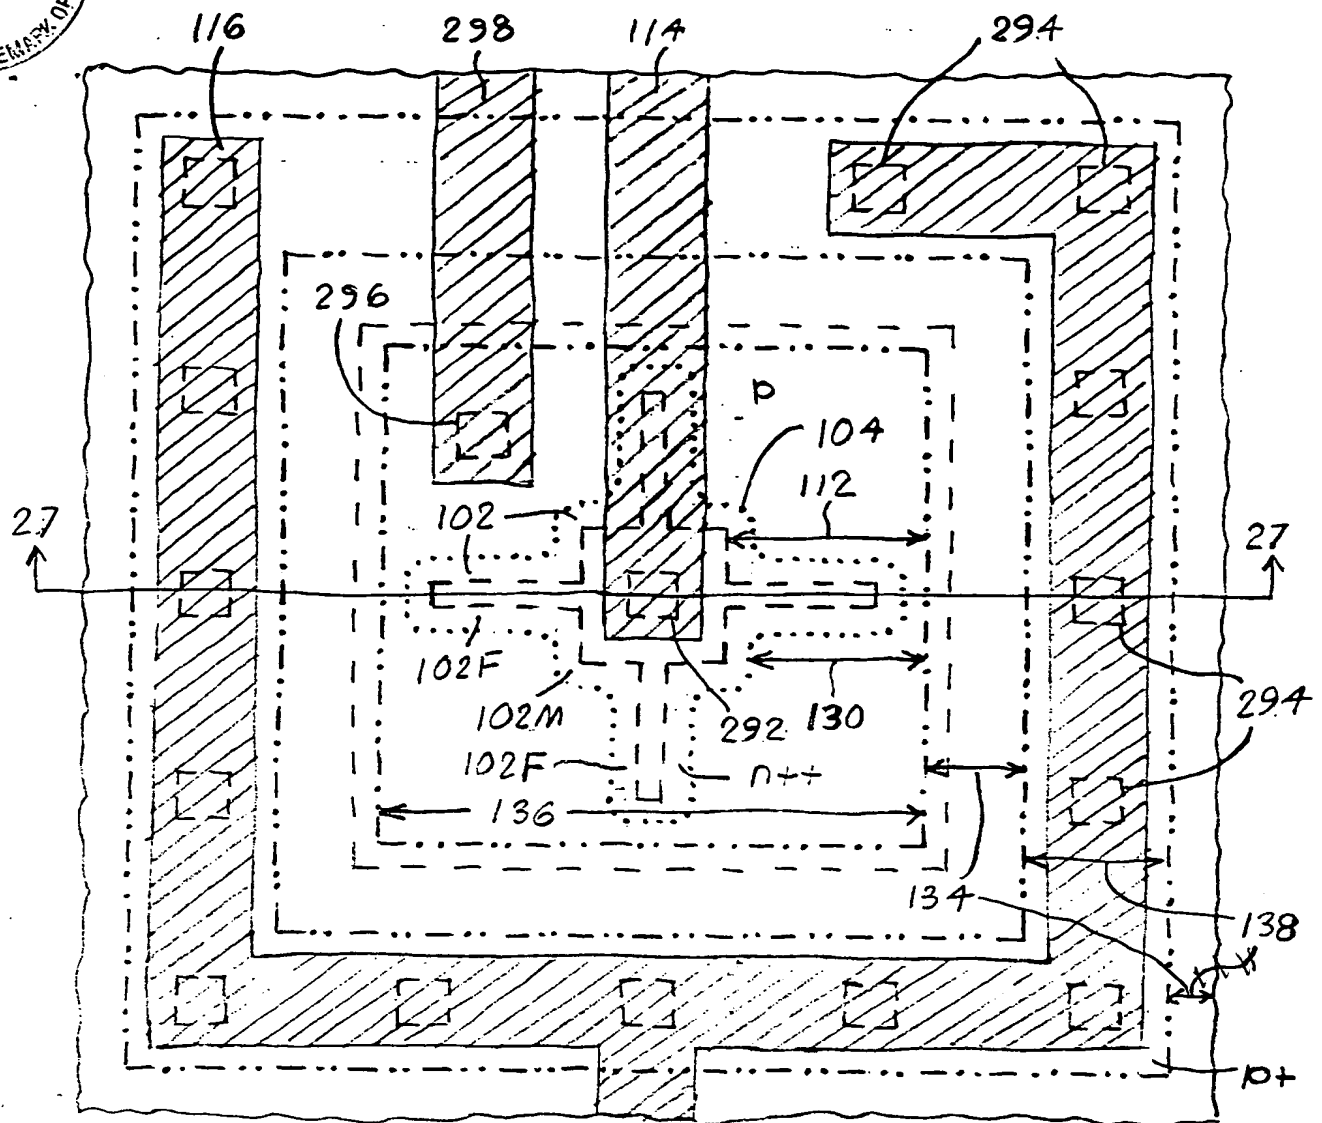


Fig. 26

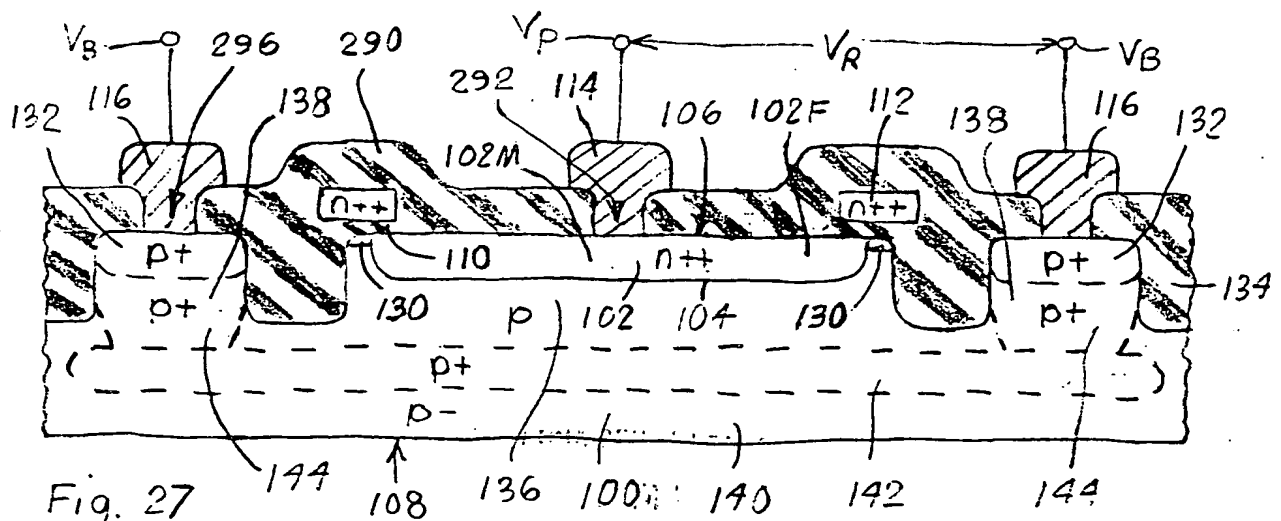


Fig. 27